


REFERENCE:  
AERIAL IMAGERY PROVIDED BY  
CONNECT EXPLORER WITH AN IMAGERY  
DATE OF 05-07-19.



CONTRACTOR SHALL CONTACT DIGSAFE AT 811 FOR  
LOCATION STAKE-OUT OF ALL UTILITIES. AT LEAST 72  
HOURS PRIOR TO ANY EXCAVATION. REFER TO  
WWW.DIGSAFE.COM FOR ADDITIONAL INFORMATION.

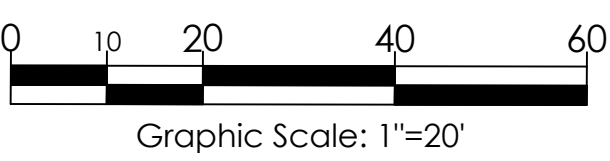

- ☐ Approved in compliance
- ☒ Approved as noted
- ☐ Revise and resubmit

DATE: 06/05/2020

1 YEAR VALIDATION  
APPROVAL SUBJECT TO PROGRAM AND IMAGE CHANGE

GENERAL NOTES

- 1.FOR NEW RESTAURANTS: ALL SIGNAGE AND DRIVE THRU ORDER STATION(S) TO BE 2020 IMAGE COMPLIANT.
- 2.FOR REMODELS: ALL EXTERIOR MENU BOARDS ARE TO BE REPLACED WITH APPROVED DIGITAL MODELS.
- 3.DIGITAL PREVIEW BOARDS ARE OPTIONAL, BUT HIGHLY RECOMMENDED.
- 4.EXISTING BLACK CANOPIES ARE ONLY APPROVED WHEN DT LAYOUT IS NOT CHANGING.
- 5.LANDSCAPING IS REQUIRED AT DRIVE THRU ORDER STATION(S) AND OTHER AREAS. REFER TO BKC LANDSCAPE GUIDELINES.
- 6.ALL REPAIR AND MAINTENANCE WORK TO BE IN ACCORDANCE WITH THE WALKTHRU INSPECTION (FACILITY INSPECTION REPORT).
- 7.COMPLIANCE WITH ALL LOCAL, STATE, AND NATIONAL CODES IS REQUIRED, INCLUDING THE AMERICANS WITH DISABILITIES ACT.
- 8.TRASH ENCLOSURE COLOR TO MATCH BUILDING.
- 9.SHOW ADA ACCESSIBLE PATH OF TRAVEL FROM BUILDING TO SIDEWALK IN ROW.
- 10.SITE SURFACE AND STRIPPING MUST BE IN GOOD CONDITIONS, CONTRARILY, UPGRADE PER STANDARDS.
- 11.LANDSCAPING:
  - DRIVE THRU LANE MUST BE FULLY LANDSCAPED AS PER STANDARDS
  - CONCRETE, ROCK/STONE IS NOT CONSIDERED LANDSCAPING
  - FOR REMODELS, LANDSCAPING MUST BE IN GOOD CONDITIONS, CONTRARILY, UPGRADE PER STANDARDS

DRIVE-THRU GENERAL NOTES:

1. ASSURE DRAWING REFLECTS ORDER STATION GEOMETRY AND DIGITAL MENU BOARDS PER BK STANDARDS
  2. OCU BOARDS SHOULD BE PLACED AT 5TH / 6TH CAR FROM PICKUP WINDOW FOR PROPER SPEED OF SERVICE
  3. ASSURE PROPER LANDSCAPE IS PROVIDED:
    - DRIVE THRU LANE MUST BE FULLY LANDSCAPED AS PER STANDARDS
    - CONCRETE, ROCK/STONE IS NOT CONSIDERED LANDSCAPING
    - FOR REMODELS, LANDSCAPING MUST BE IN GOOD CONDITIONS, CONTRARILY, UPGRADE PER STANDARDS
- BLACK CONCRETE LINE. 9' PAST THE CENTERLINE OF THE DT PICKUP WINDOW.

SITE REQUIREMENTS:

- DOUBLE DRIVE THRU ☒
- DIGITAL MENU BOARDS ☒
- BUMPOUTS ☒
- EXPEDITING DOORS ☒
- BYPASS LANE ☒

no per existing building conditions

Issued: Date:

A		
B		
C		
D		
E		
F		
G		
H		

Revisions: Date:

1		
2		
3		
4		
5		
6		
7		
8		

FOR APPROVAL ONLY/NO FOR CONSTRUCTION

Seal Seal

CIVIL ENGINEER OF RECORD  
Name: Todd G. Markevicz  
Registration No.: 13329  
Exp. Date: June 30, 2021  
Firm No.: PE.00LLC73-COA  
Exp. Date: June 30, 2020

Copyright © 2020

A P D Engineering and Architecture PLLC

100 West 10th Street  
Providence, RI 02903

Drawing Alteration

It is a violation of law for any person, unless acting under the direction of licensed Architect, Professional Engineer, Landscape Architect, or Land Surveyor to alter any item on this document in any way. Any licensee who alters this document is required by law to affix his or her seal and to add the notation "Altered By" followed by his or her signature and the specific description of the alteration or revision.

DO NOT SCALE PLANS

Copying, Printing, Software and other processes required to produce these prints can stretch or shrink the actual paper or layout. Therefore, scaling of this drawing may be inaccurate. Contact Engineer of Record with any need for additional dimensions or clarifications.

**APD**  
**ENGINEERING**  
**ARCHITECTURE**  
615 Fishers Run Victor, NY 14564  
585.742.2222 - www.apd.com



Burger King

JSC MANAGEMENT GROUP  
ATTN: JAMES CAMMILLERI  
BURGER KING FRANCHISEE  
585.755.3950

Burger King - Store #3667

66 Eddie Dowling Highway  
Town of N. Smithfield, Rhode Island  
County of Providence  
Project Name & Location:

Concept Site Plan

Drawing Name:

Date: 05/04/20

Type: Concept

Drawn By: SLA

Scale: 1"=20'

Project No.  
20-0214  
SK1  
Drawing No.